

16: RT 3 BOUNDS AS "GOOD LINE"  
 NG ADJUSTMENTS ARE THE  
 BETWEEN THE EXISTING (FIELD)  
 IE (PLAN) LOCATIONS .....


an "as built" plan of the  
**Cypress Industrial Park**  
**BURLINGTON, MASS**

owner: *E. J. Schwaner Co*  
 scale: 1" = 40' date: JANUARY, 1967

2 1/2" x 3 1/2" ROAD  
 BURLINGTON, MASS




SUBDIVISION PLAN RECORDED M.S.R.D. PLAN 220 OF  
 REVISION OF LOTS 1 AND 5; AUG. 6, 1963 -- 629 OF  
 REVISION OF LOTS 3 AND 6

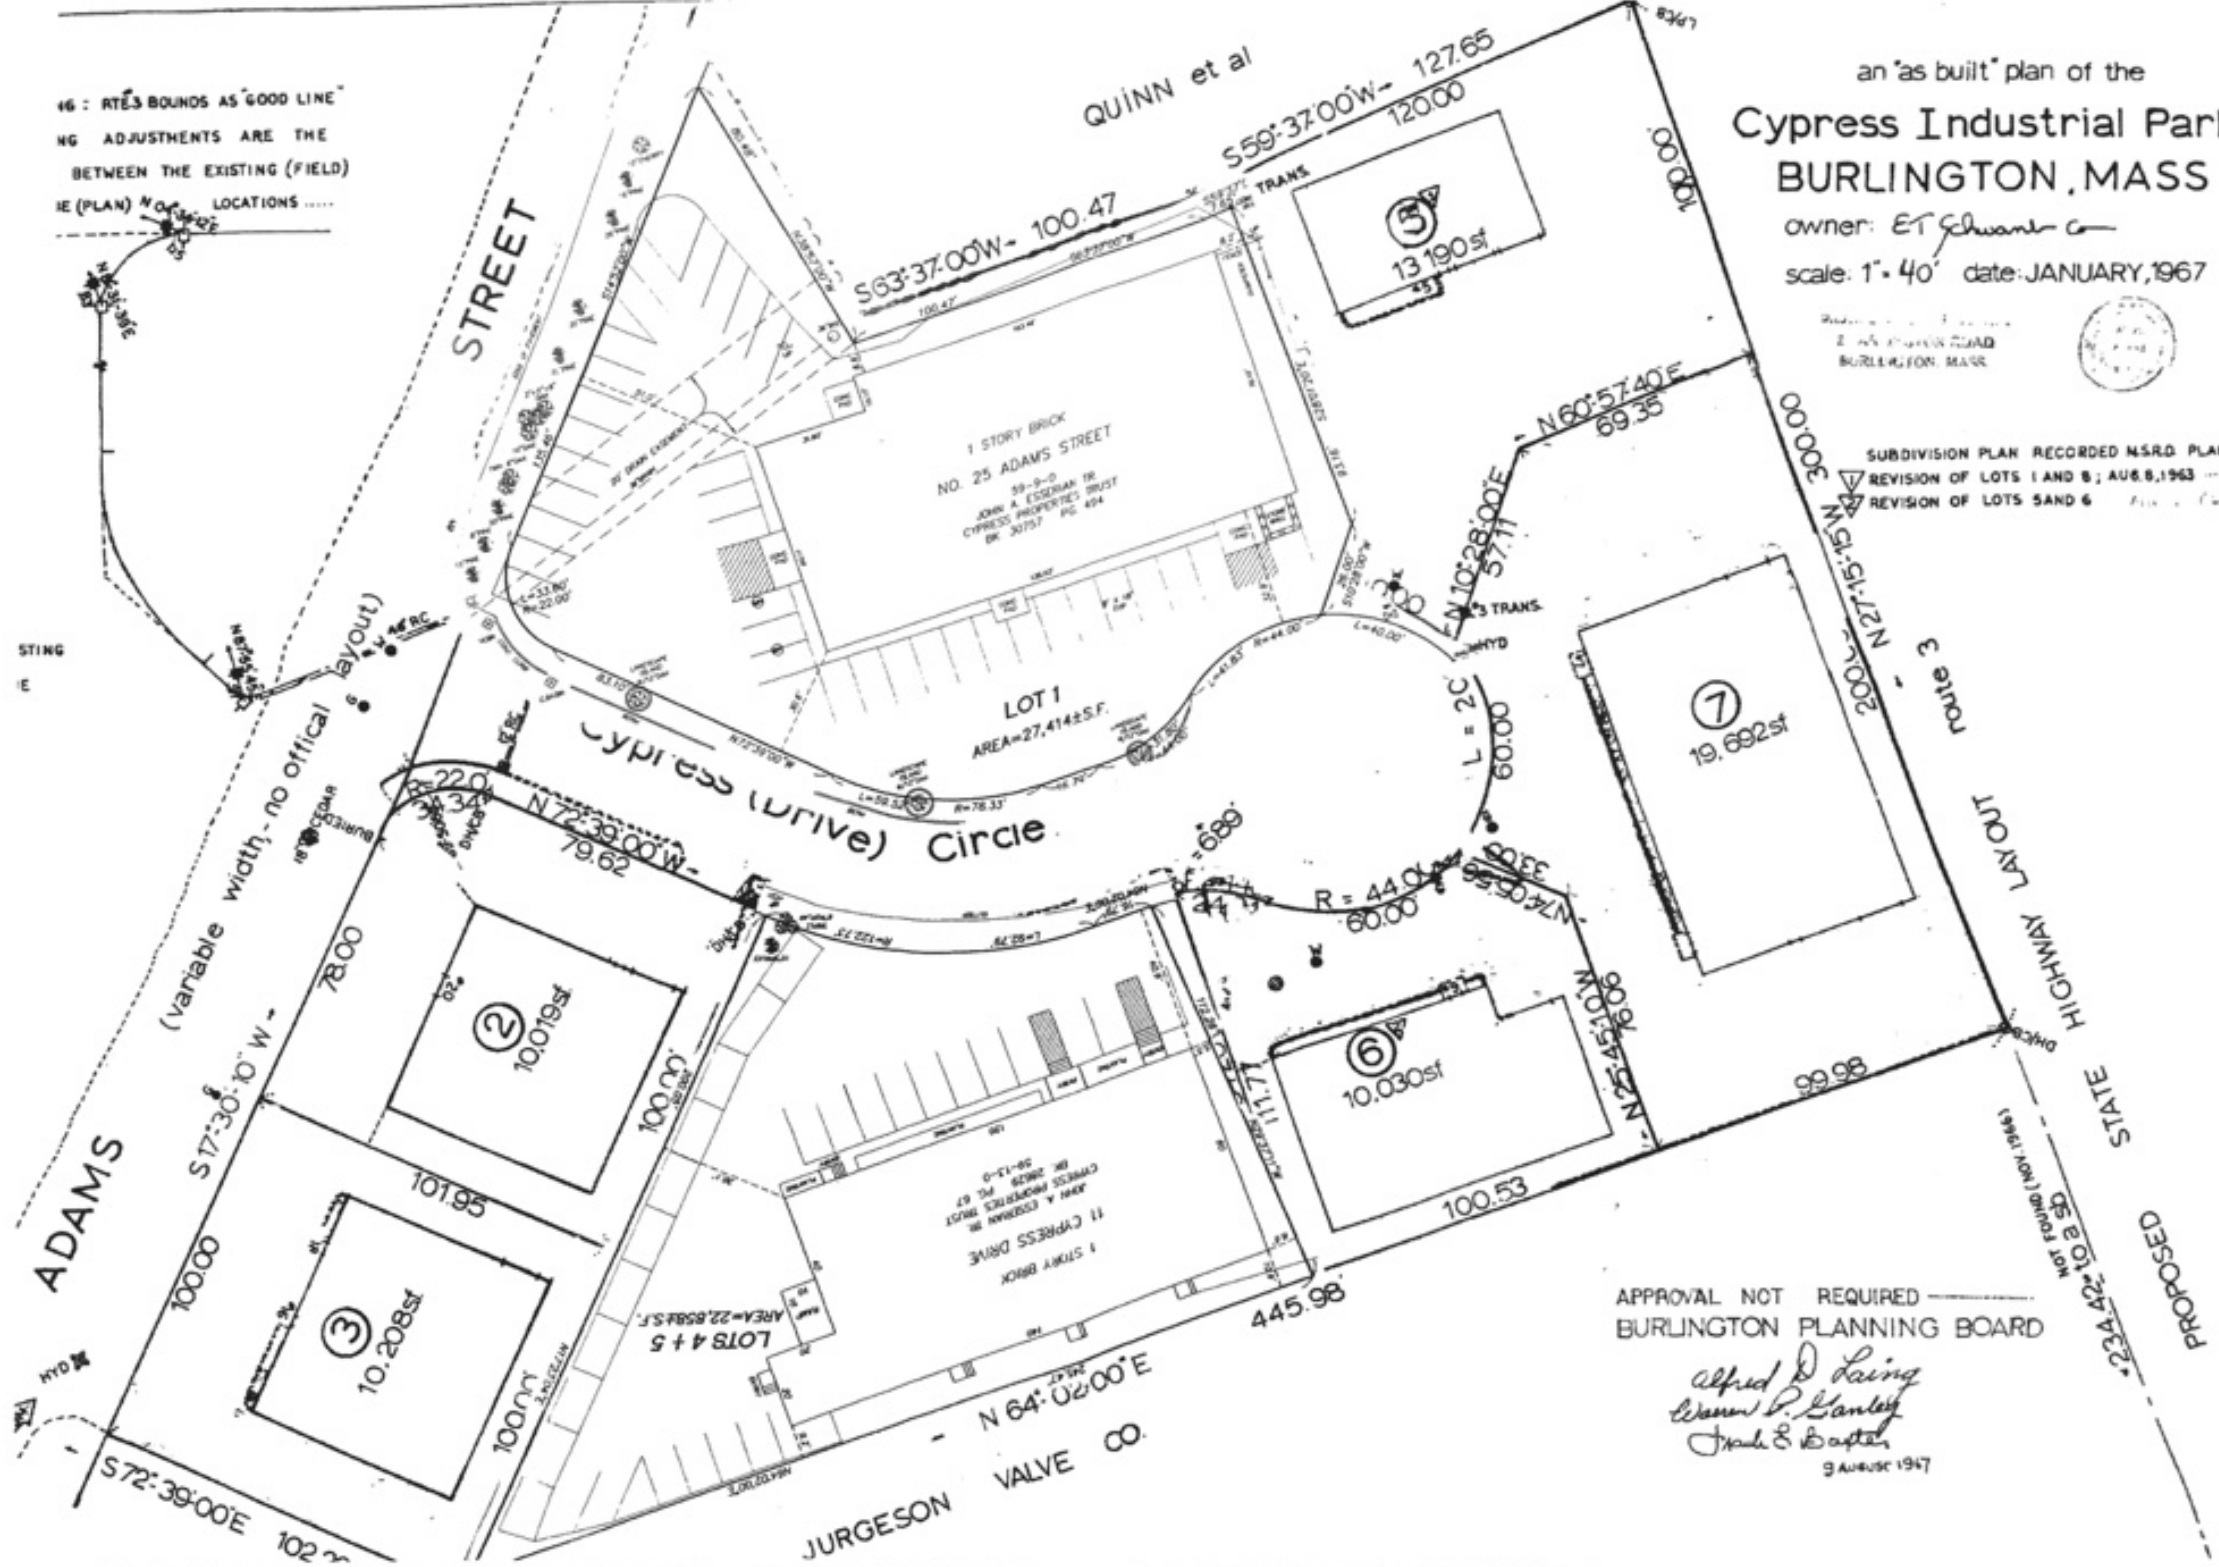

APPROVAL NOT REQUIRED  
 BURLINGTON PLANNING BOARD

*Alfred D. Laing*  
*Edward P. Stanley*  
*Frank E. Baxter*  
 9 AUGUST 1967

PROPOSED  
 STATE HIGHWAY LAY-OUT  
 NOT REQUIRED (NOT 1961)

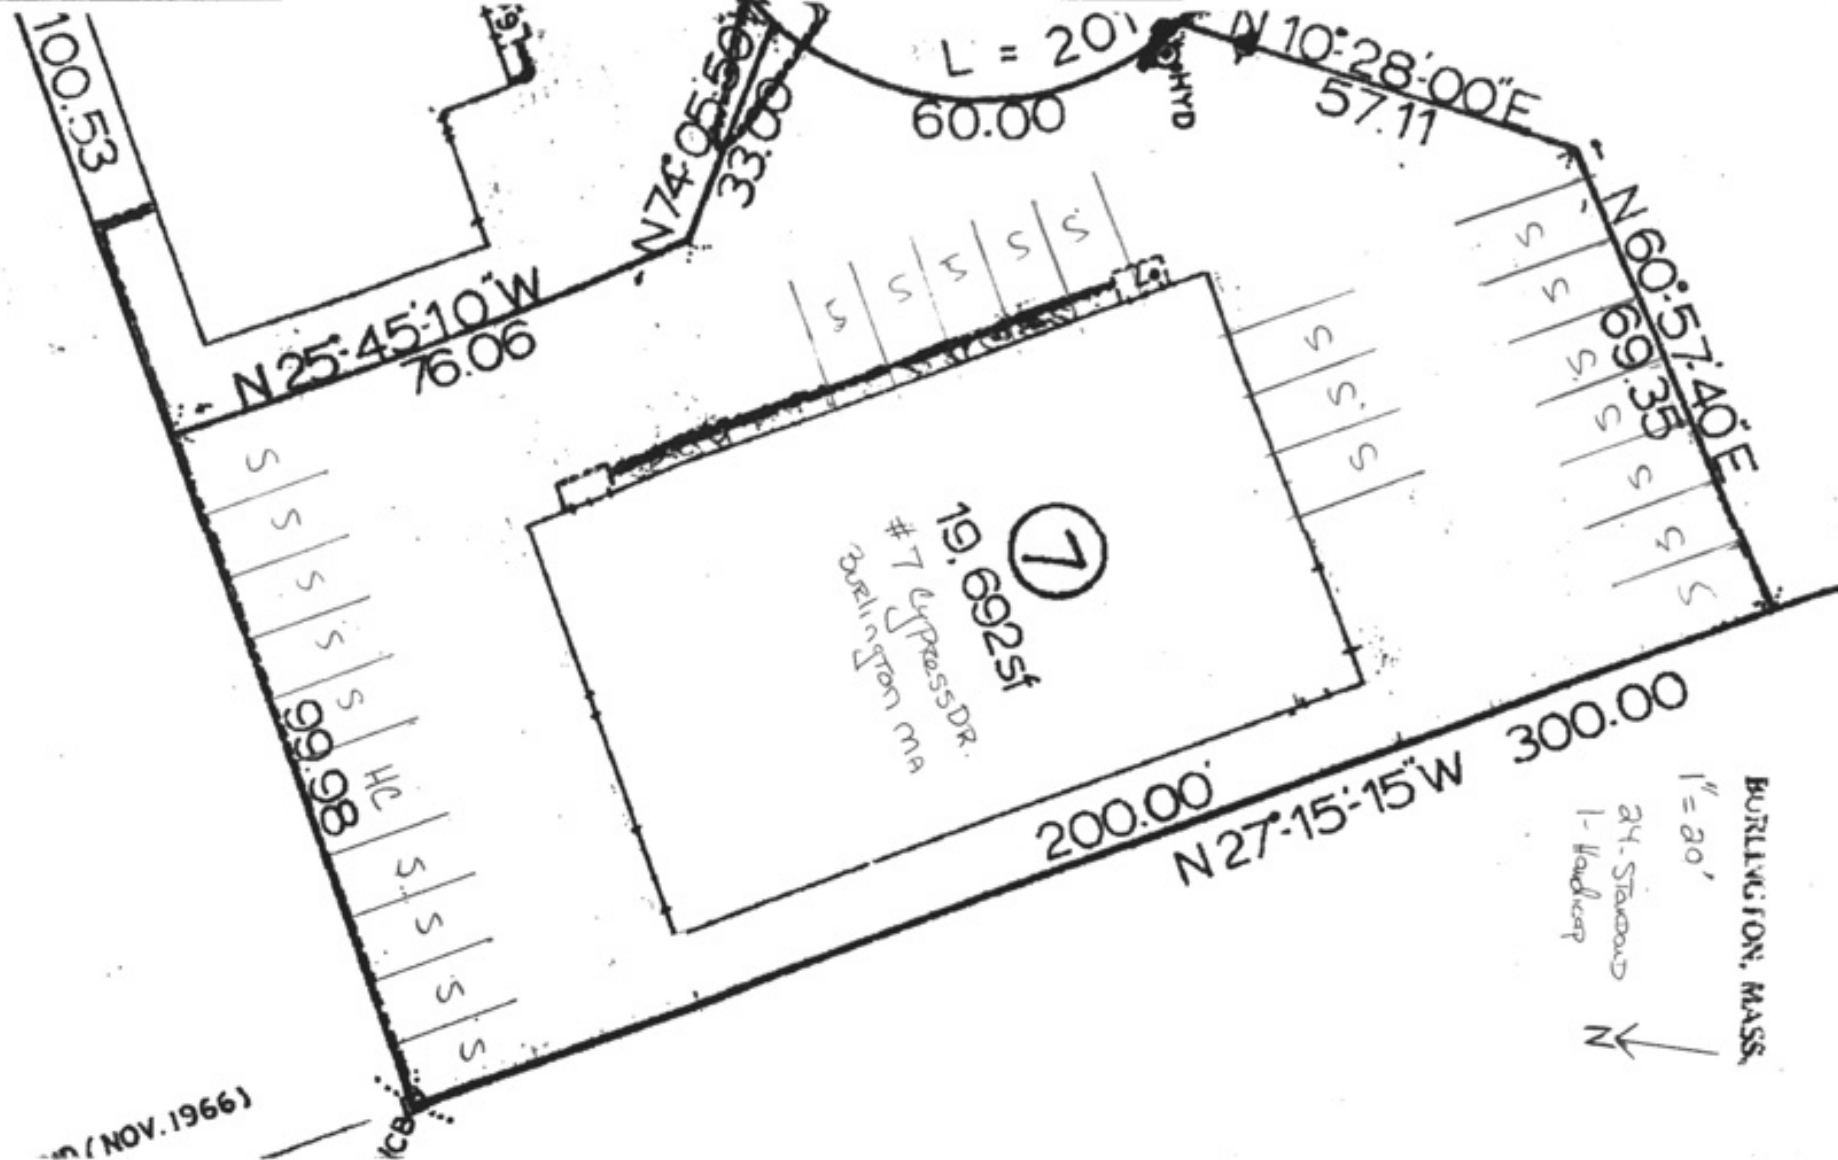

1" = 20'  
 24" STAIRS  
 1" HANDICAP  
 BURLINGTON, MASS.  
 N